




清远市英德市西牛镇落实前地块土地使用规划局部图（LS01）

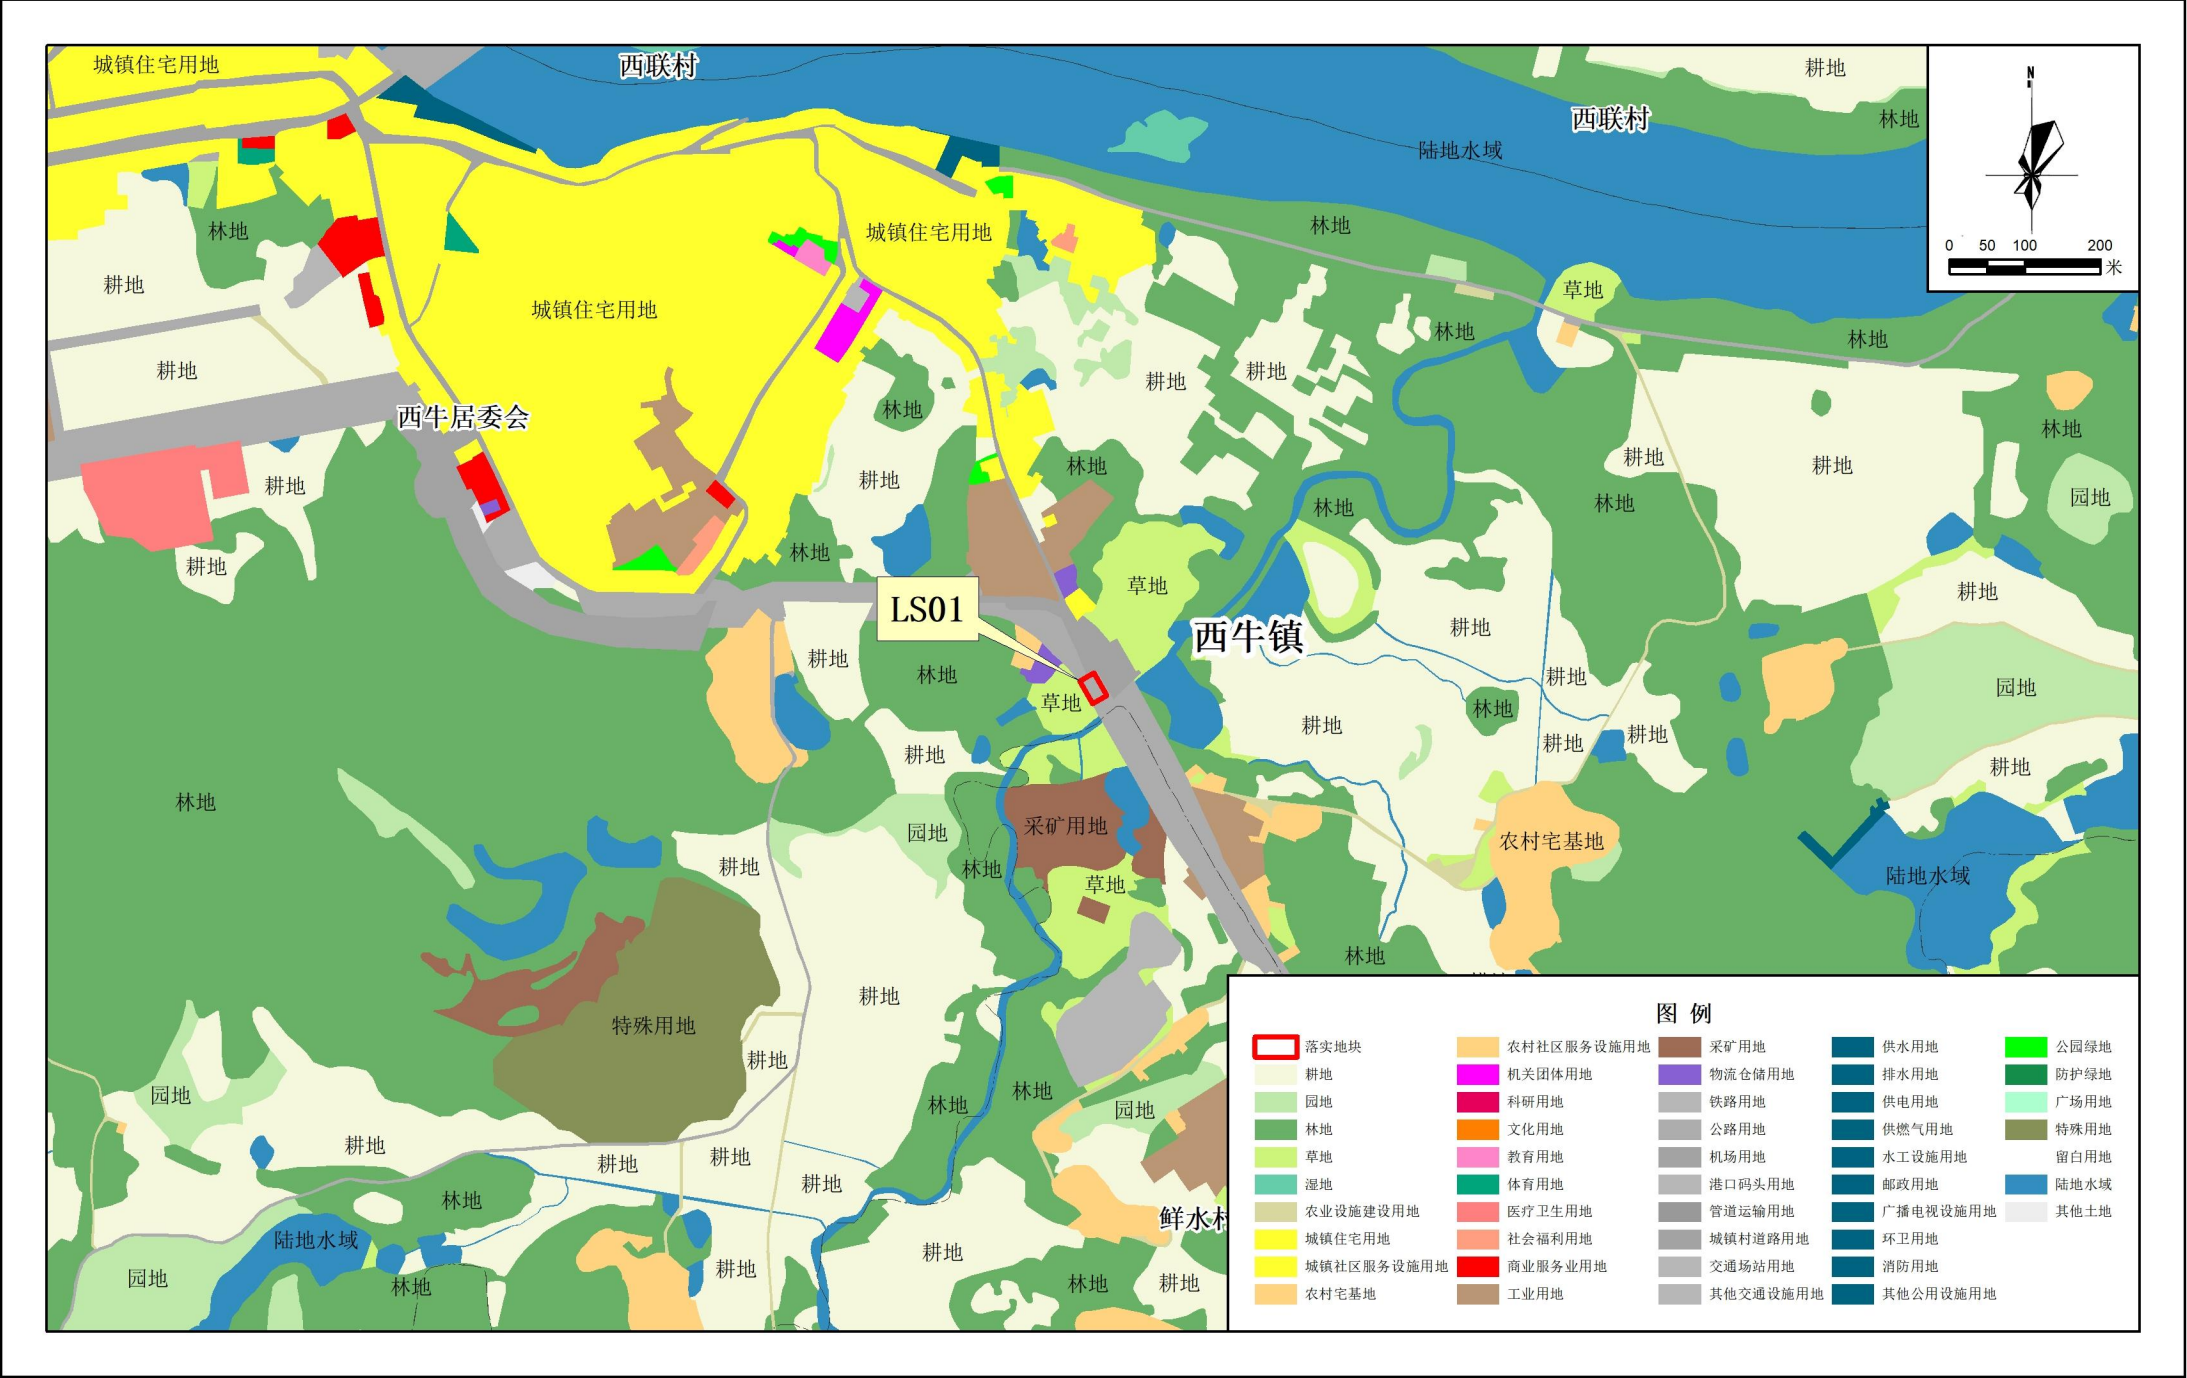


清远市英德市石灰铺镇落实后地块土地使用规划局部图（LS04）

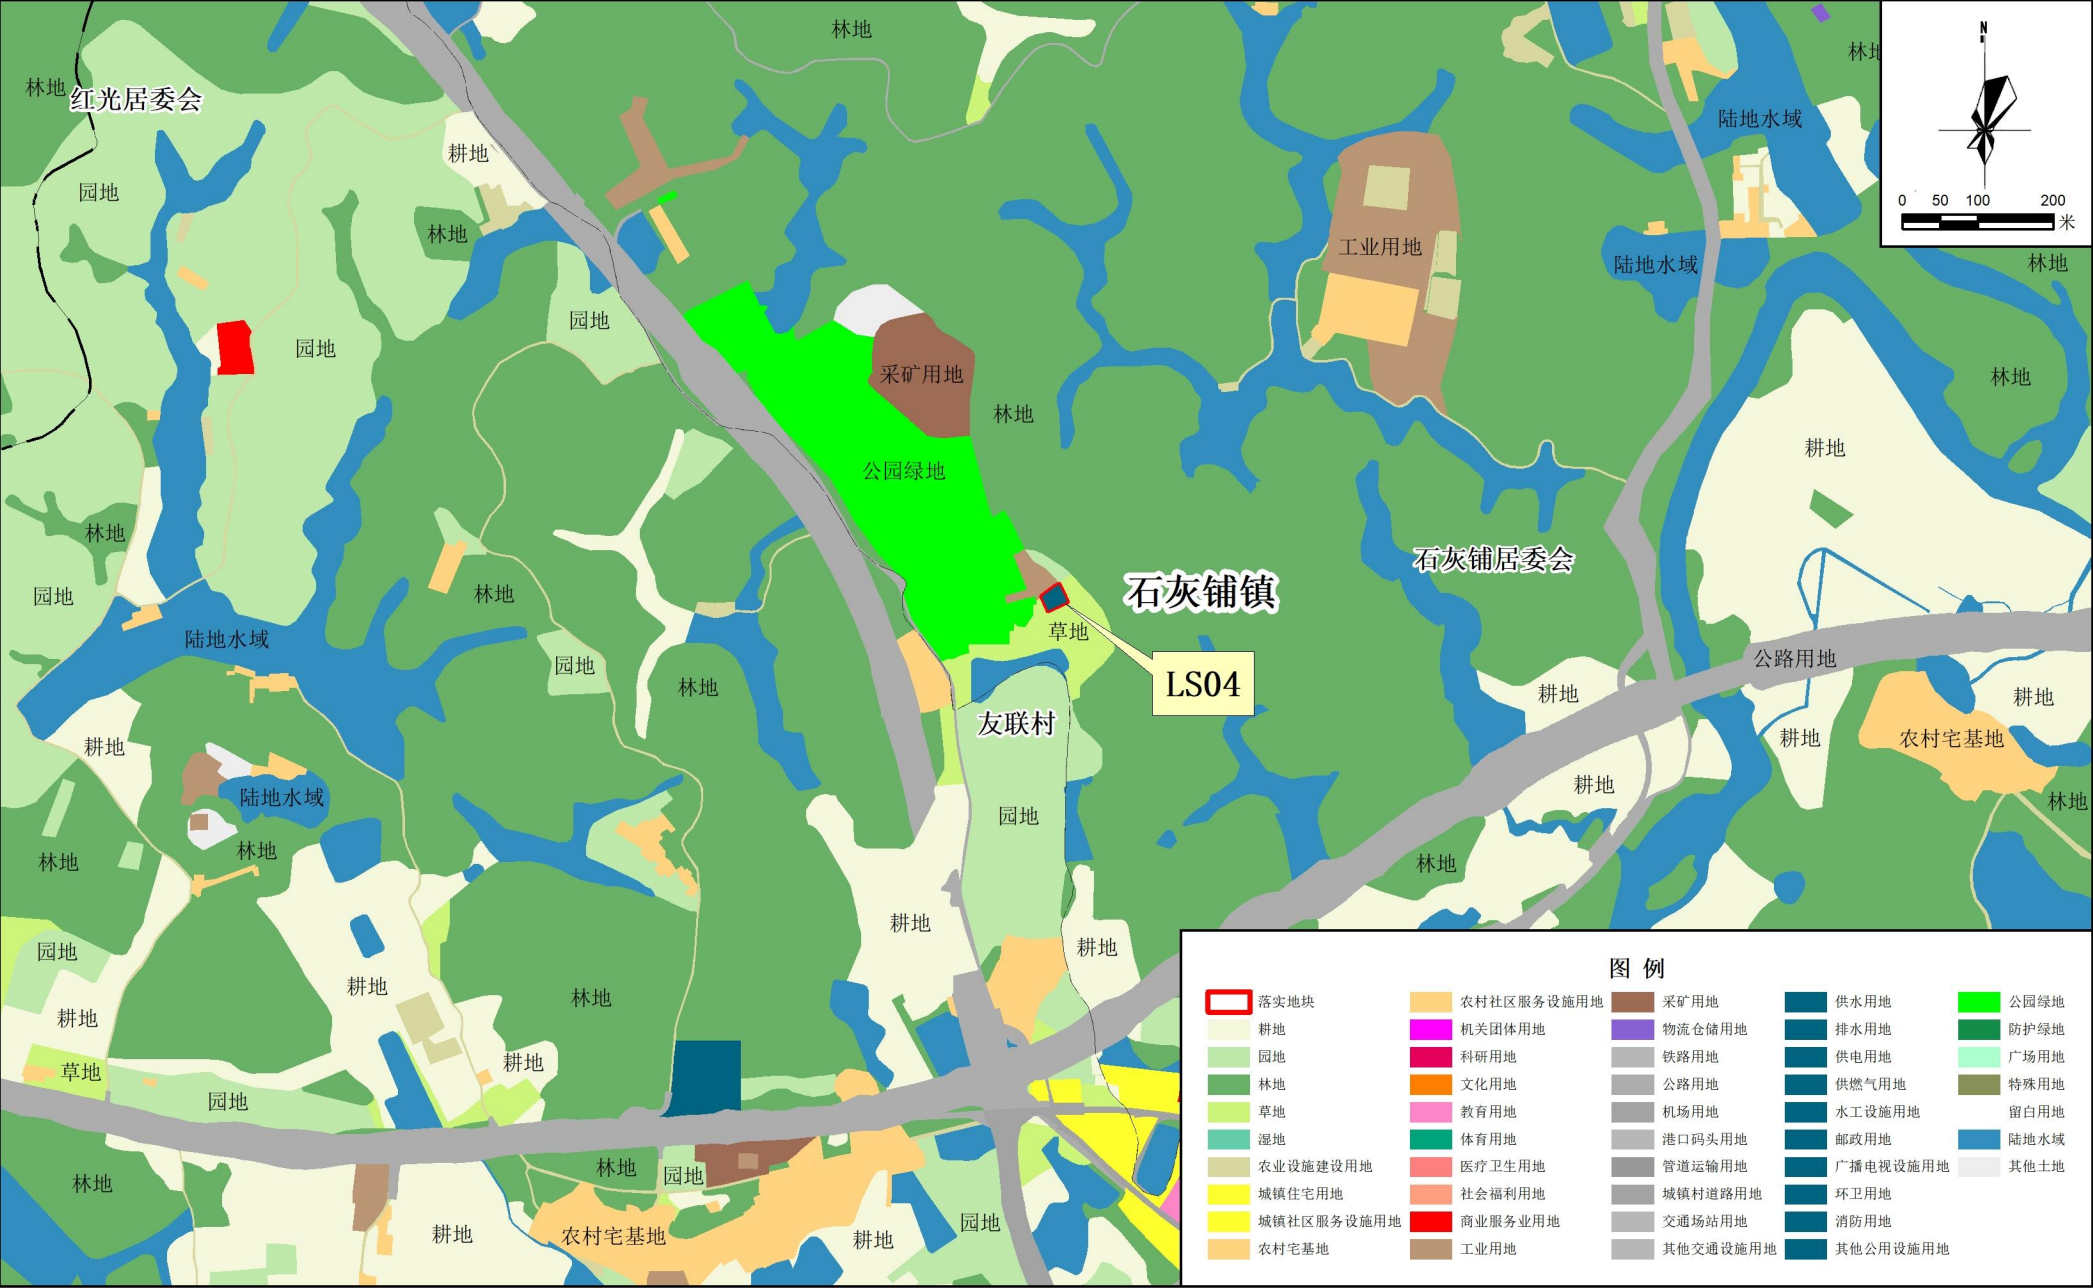

清远市英德市下（石太）镇落实后地块土地使用规划局部图（LS02-LS03）

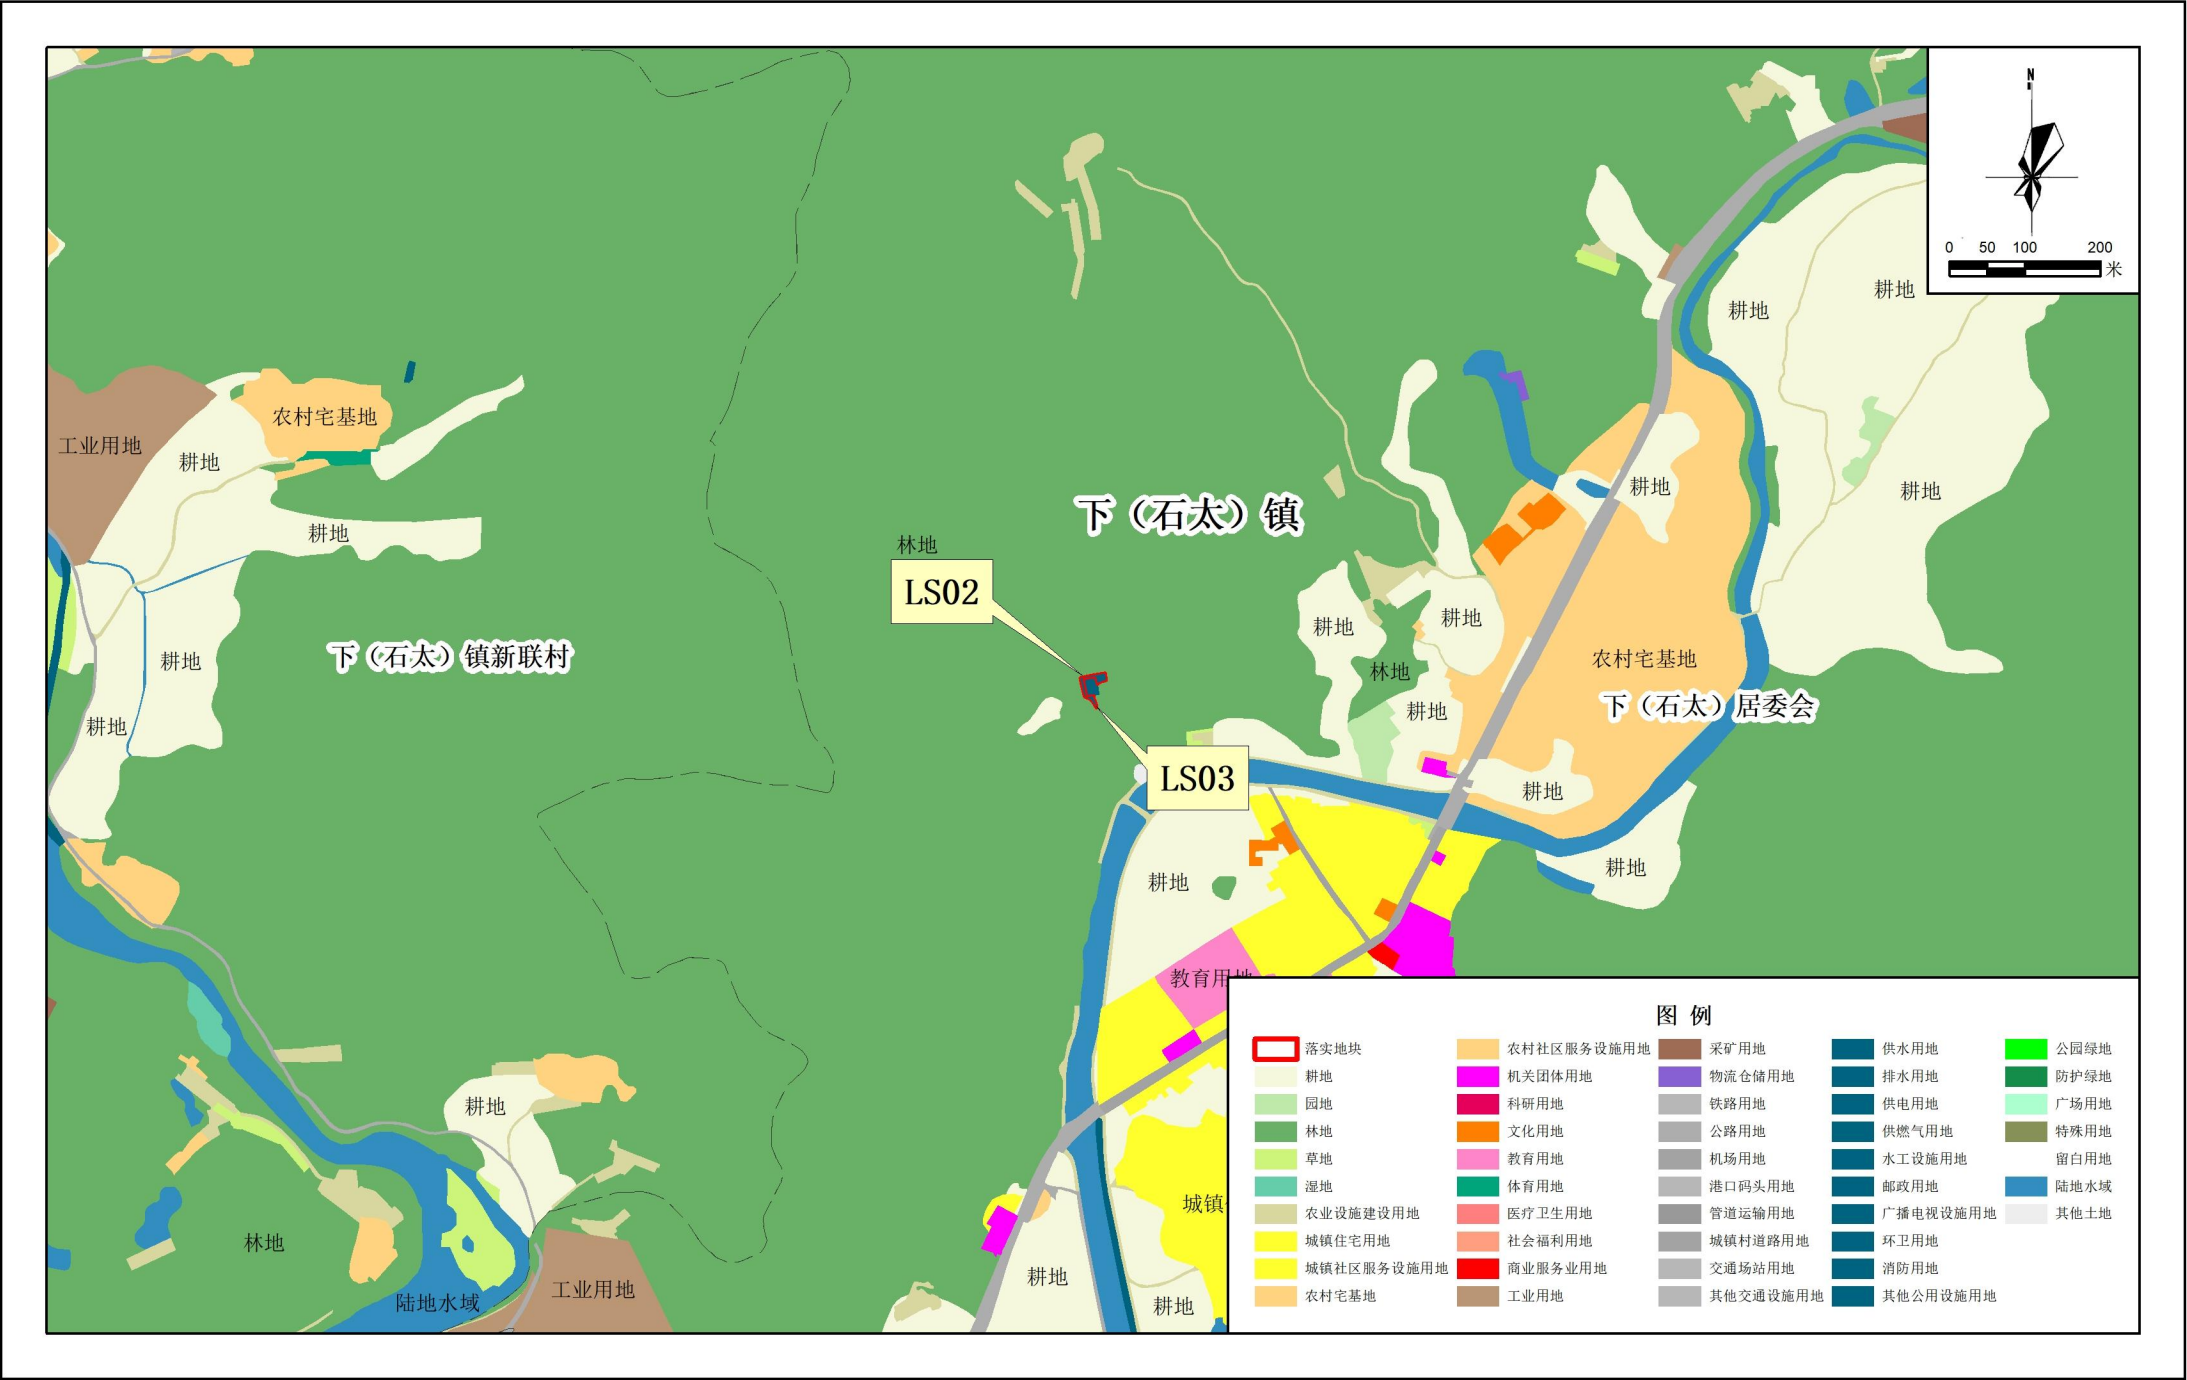

清远市英德市西牛镇落实后地块土地使用规划局部图（LS01）

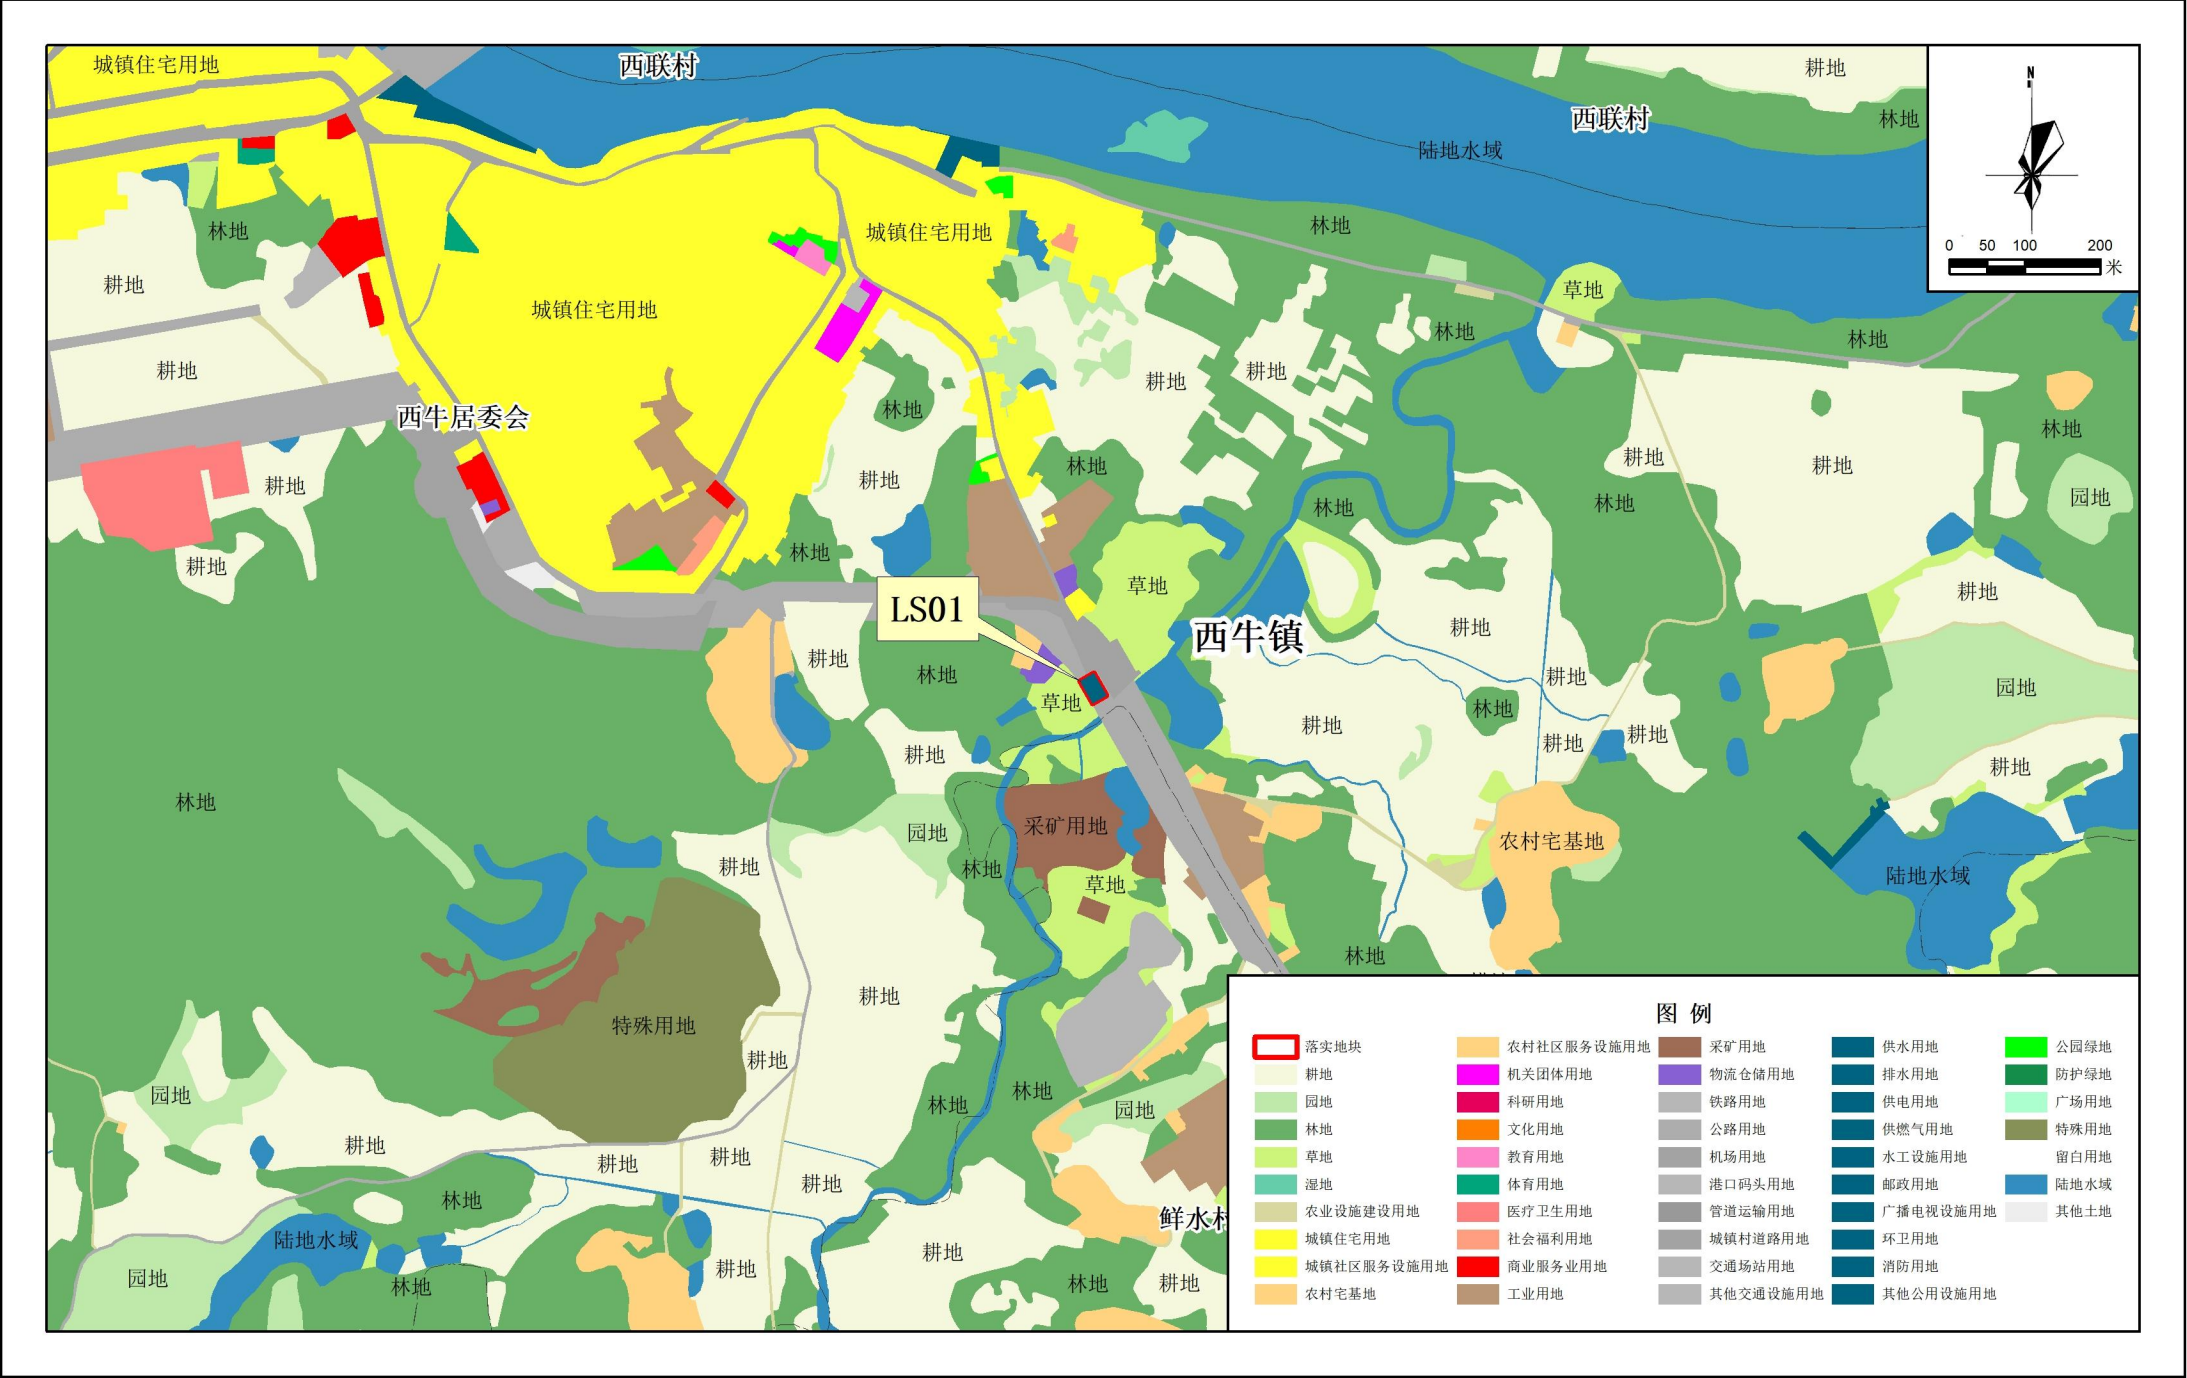


2000国家大地坐标系
1985高程基准

1: 10,000

英德市自然资源局 编制
二〇二五年七月

清远市英德市石灰铺镇落实前地块土地使用规划局部图（LS04）

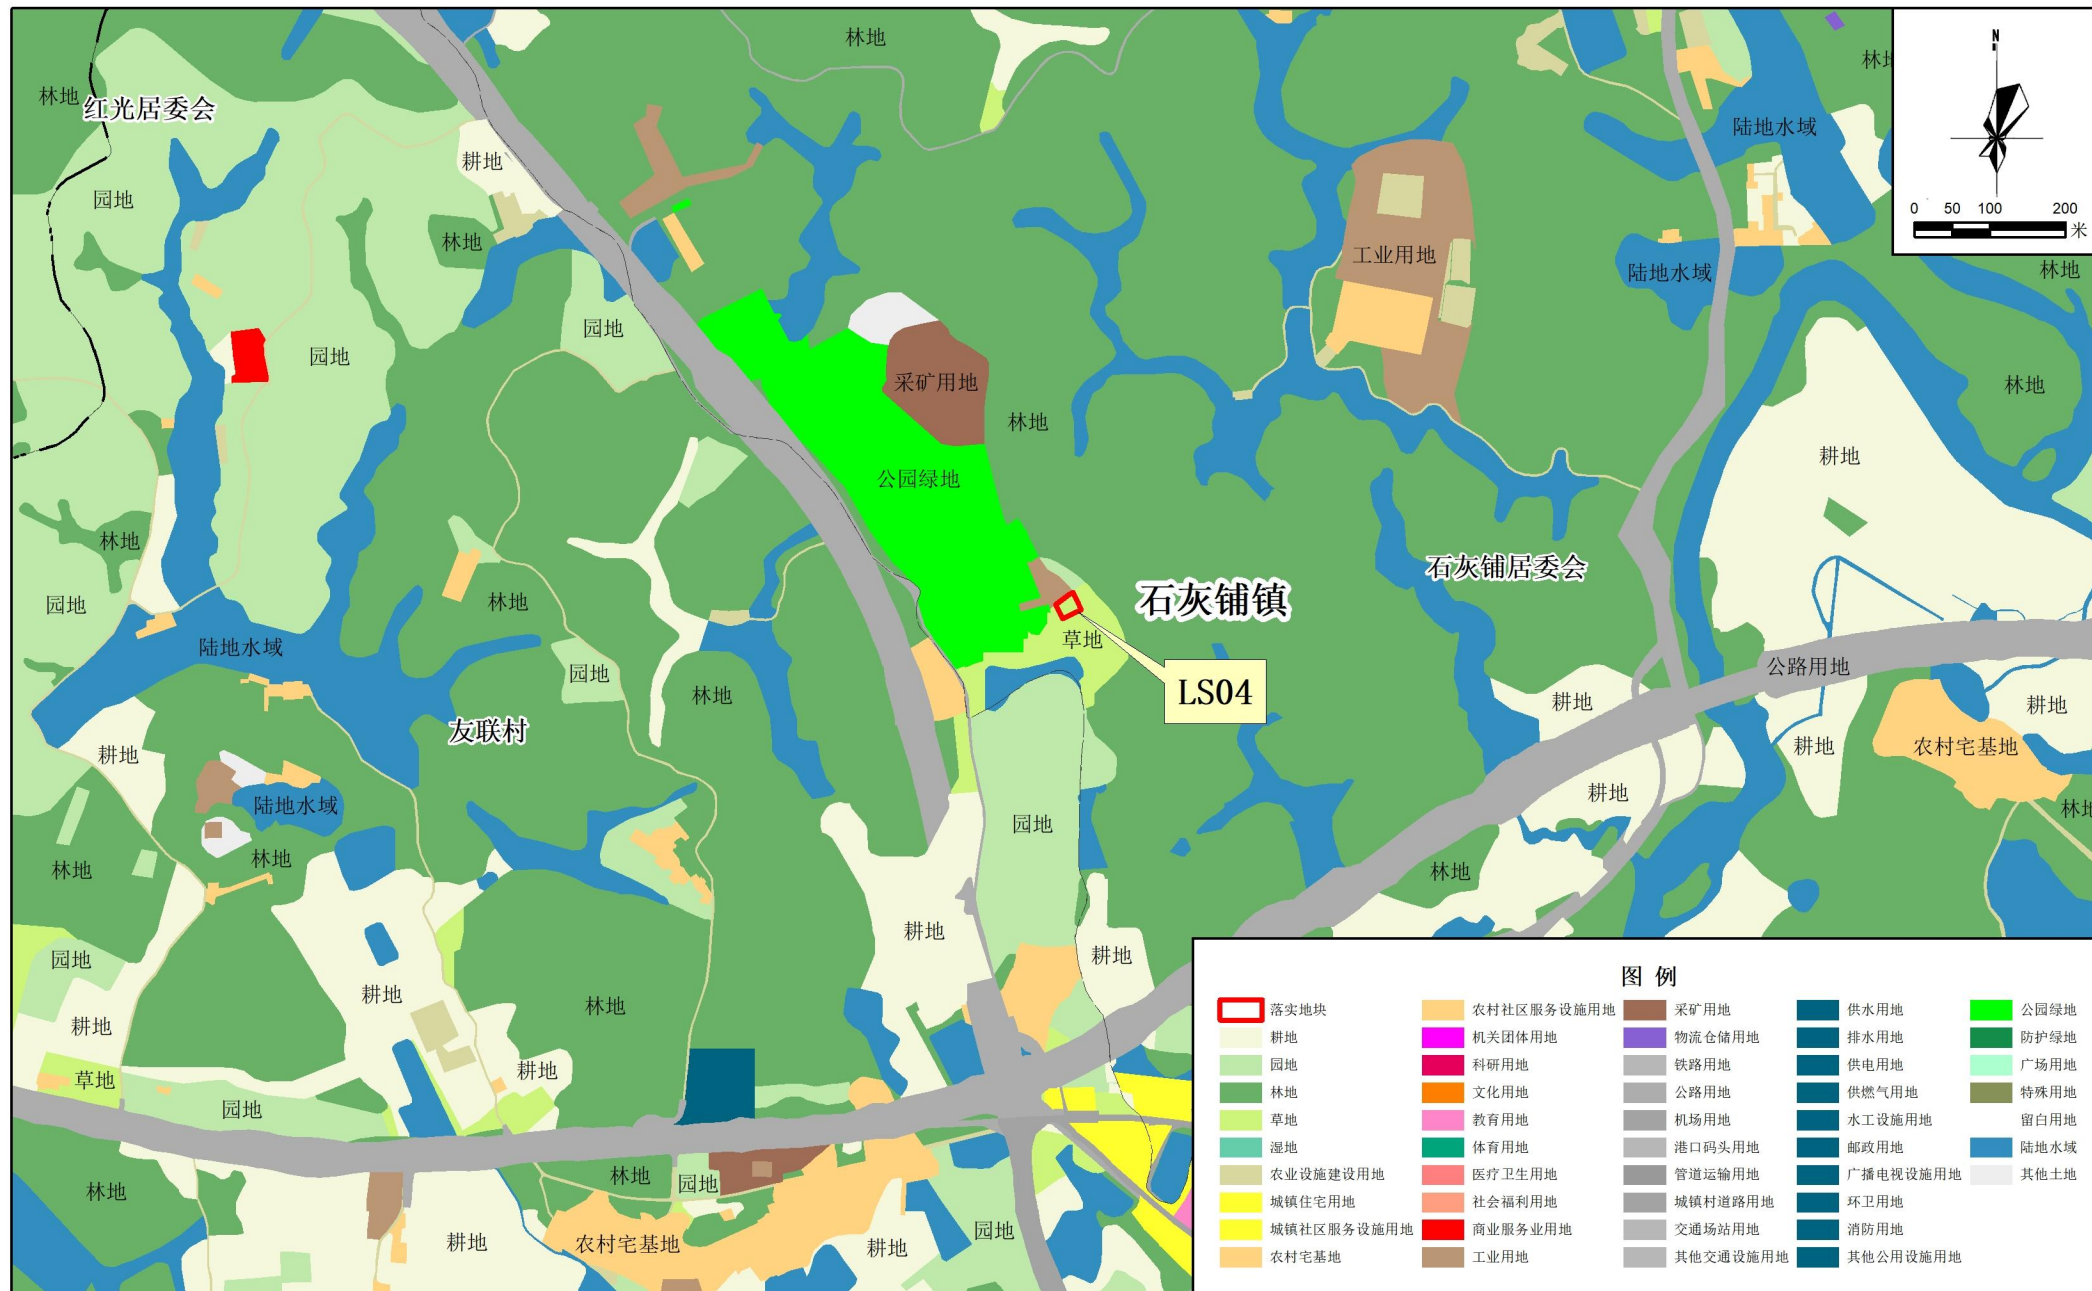


- Land Use Types:**
 - 耕地 (Agricultural Land)
 - 林地 (Forest Land)
 - 草地 (Grassland)
 - 湿地 (Wetland)
 - 农业设施建设用地 (Agricultural Facility Construction Land)
 - 城镇住宅用地 (Urban Residential Land)
 - 城镇社区服务设施用地 (Urban Community Service Facility Land)
 - 农村宅基地 (Rural Homesteads)
 - 农村社区服务设施用地 (Rural Community Service Facility Land)
 - 机关团体用地 (Government and Institutional Land)
 - 科研用地 (Research Land)
 - 文化用地 (Cultural Land)
 - 教育用地 (Education Land)
 - 体育用地 (Sports Land)
 - 医疗卫生用地 (Medical and Health Land)
 - 社会福利用地 (Social Welfare Land)
 - 商业服务业用地 (Commercial and Service Land)
 - 工业用地 (Industrial Land)
 - 采矿用地 (Mining Land)
 - 物流仓储用地 (Logistics and Warehouse Land)
 - 铁路用地 (Railway Land)
 - 公路用地 (Road Land)
 - 机场用地 (Airport Land)
 - 港口码头用地 (Port and Wharf Land)
 - 管道运输用地 (Pipeline Transport Land)
 - 城镇村道路用地 (Urban and Village Road Land)
 - 交通场站用地 (Transportation Station Land)
 - 其他交通设施用地 (Other Transportation Facility Land)
 - 供水用地 (Water Supply Land)
 - 排水用地 (Drainage Land)
 - 供电用地 (Power Supply Land)
 - 供燃气用地 (Gas Supply Land)
 - 水工设施用地 (Water Engineering Facility Land)
 - 邮政用地 (Post Land)
 - 广播电视设施用地 (Radio and Television Facility Land)
 - 环卫用地 (Sanitation Land)
 - 消防用地 (Fire Protection Land)
 - 其他公用设施用地 (Other Public Facility Land)
 - 公园绿地 (Park Green Space)
 - 防护绿地 (Protection Green Space)
 - 广场用地 (Plaza Land)
 - 特殊用地 (Special Land)
 - 留白用地 (Blank Land)
 - 陆地水域 (Terrestrial Water Body)
 - 其他土地 (Other Land)
- Map Features:**
 - 图例 (Legend):** Located at the bottom right, detailing the color-coded land use categories.
 - Scale:** A scale bar at the top right indicates distances of 0, 50, 100, and 200 meters.
 - North Arrow:** A north arrow is positioned at the top right, pointing towards the top of the map.
